



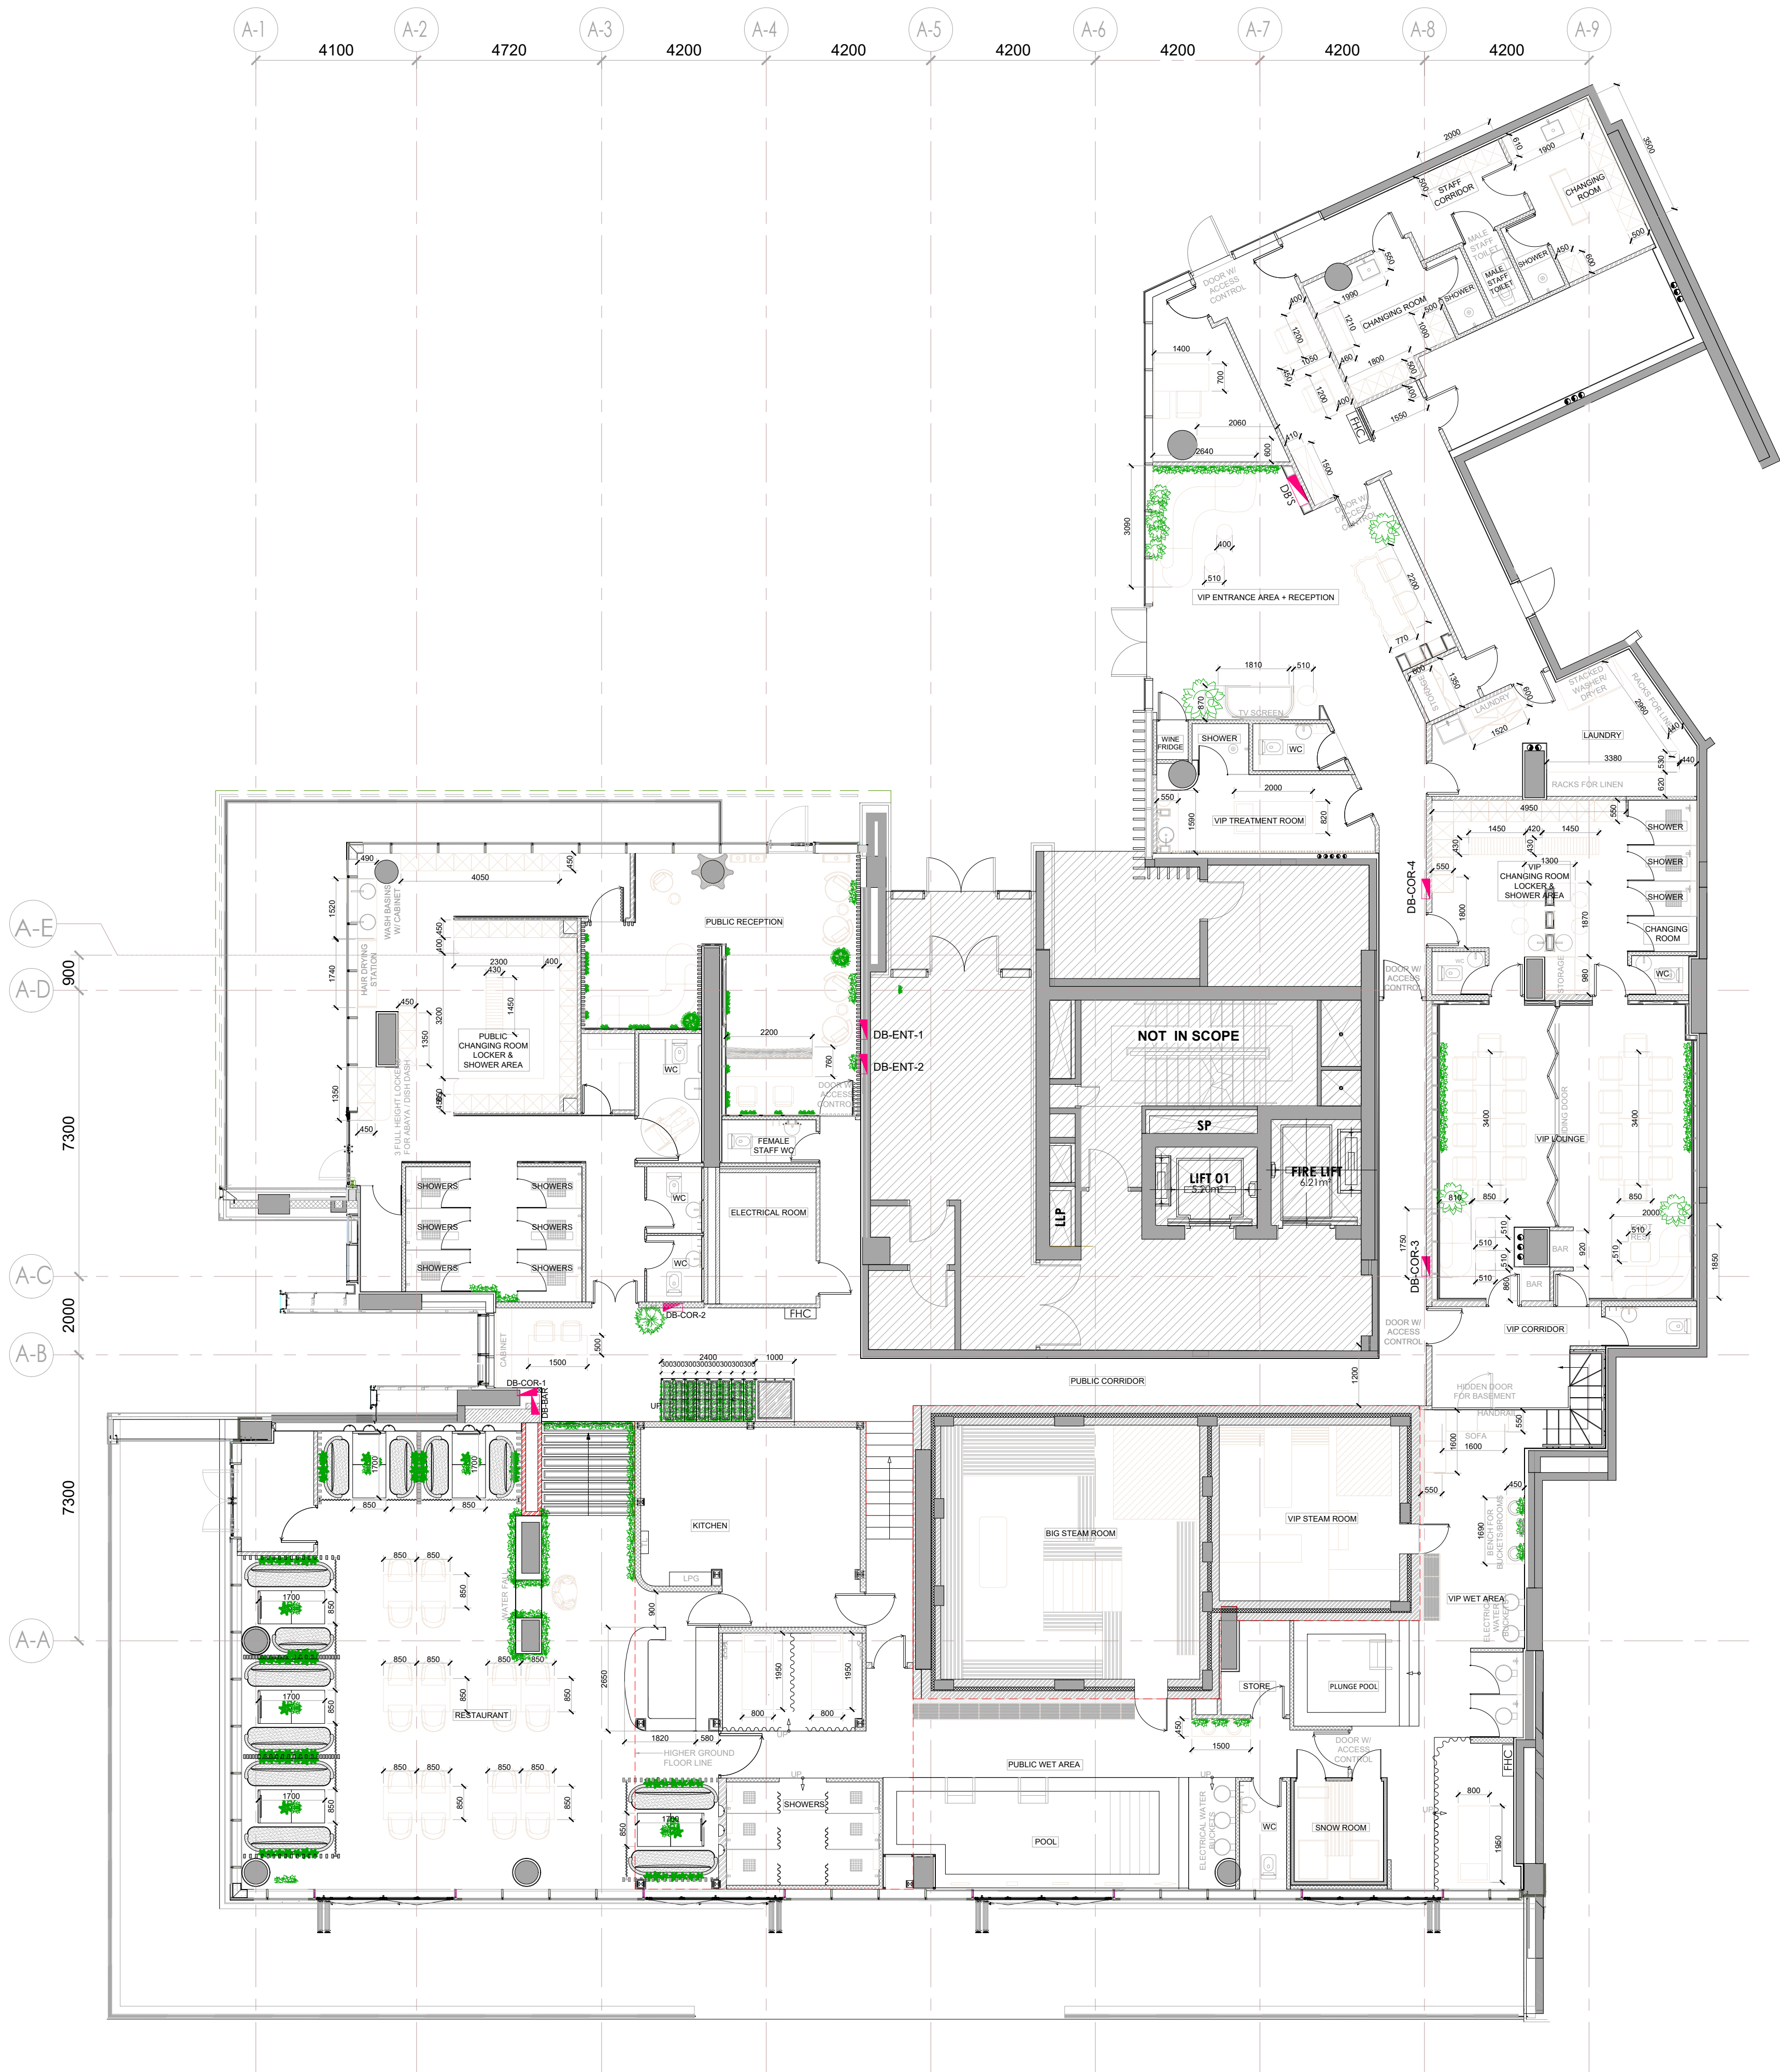


01 GROUND FLOOR FURNITURE DIMENSION PLAN
SCALE: 1:200

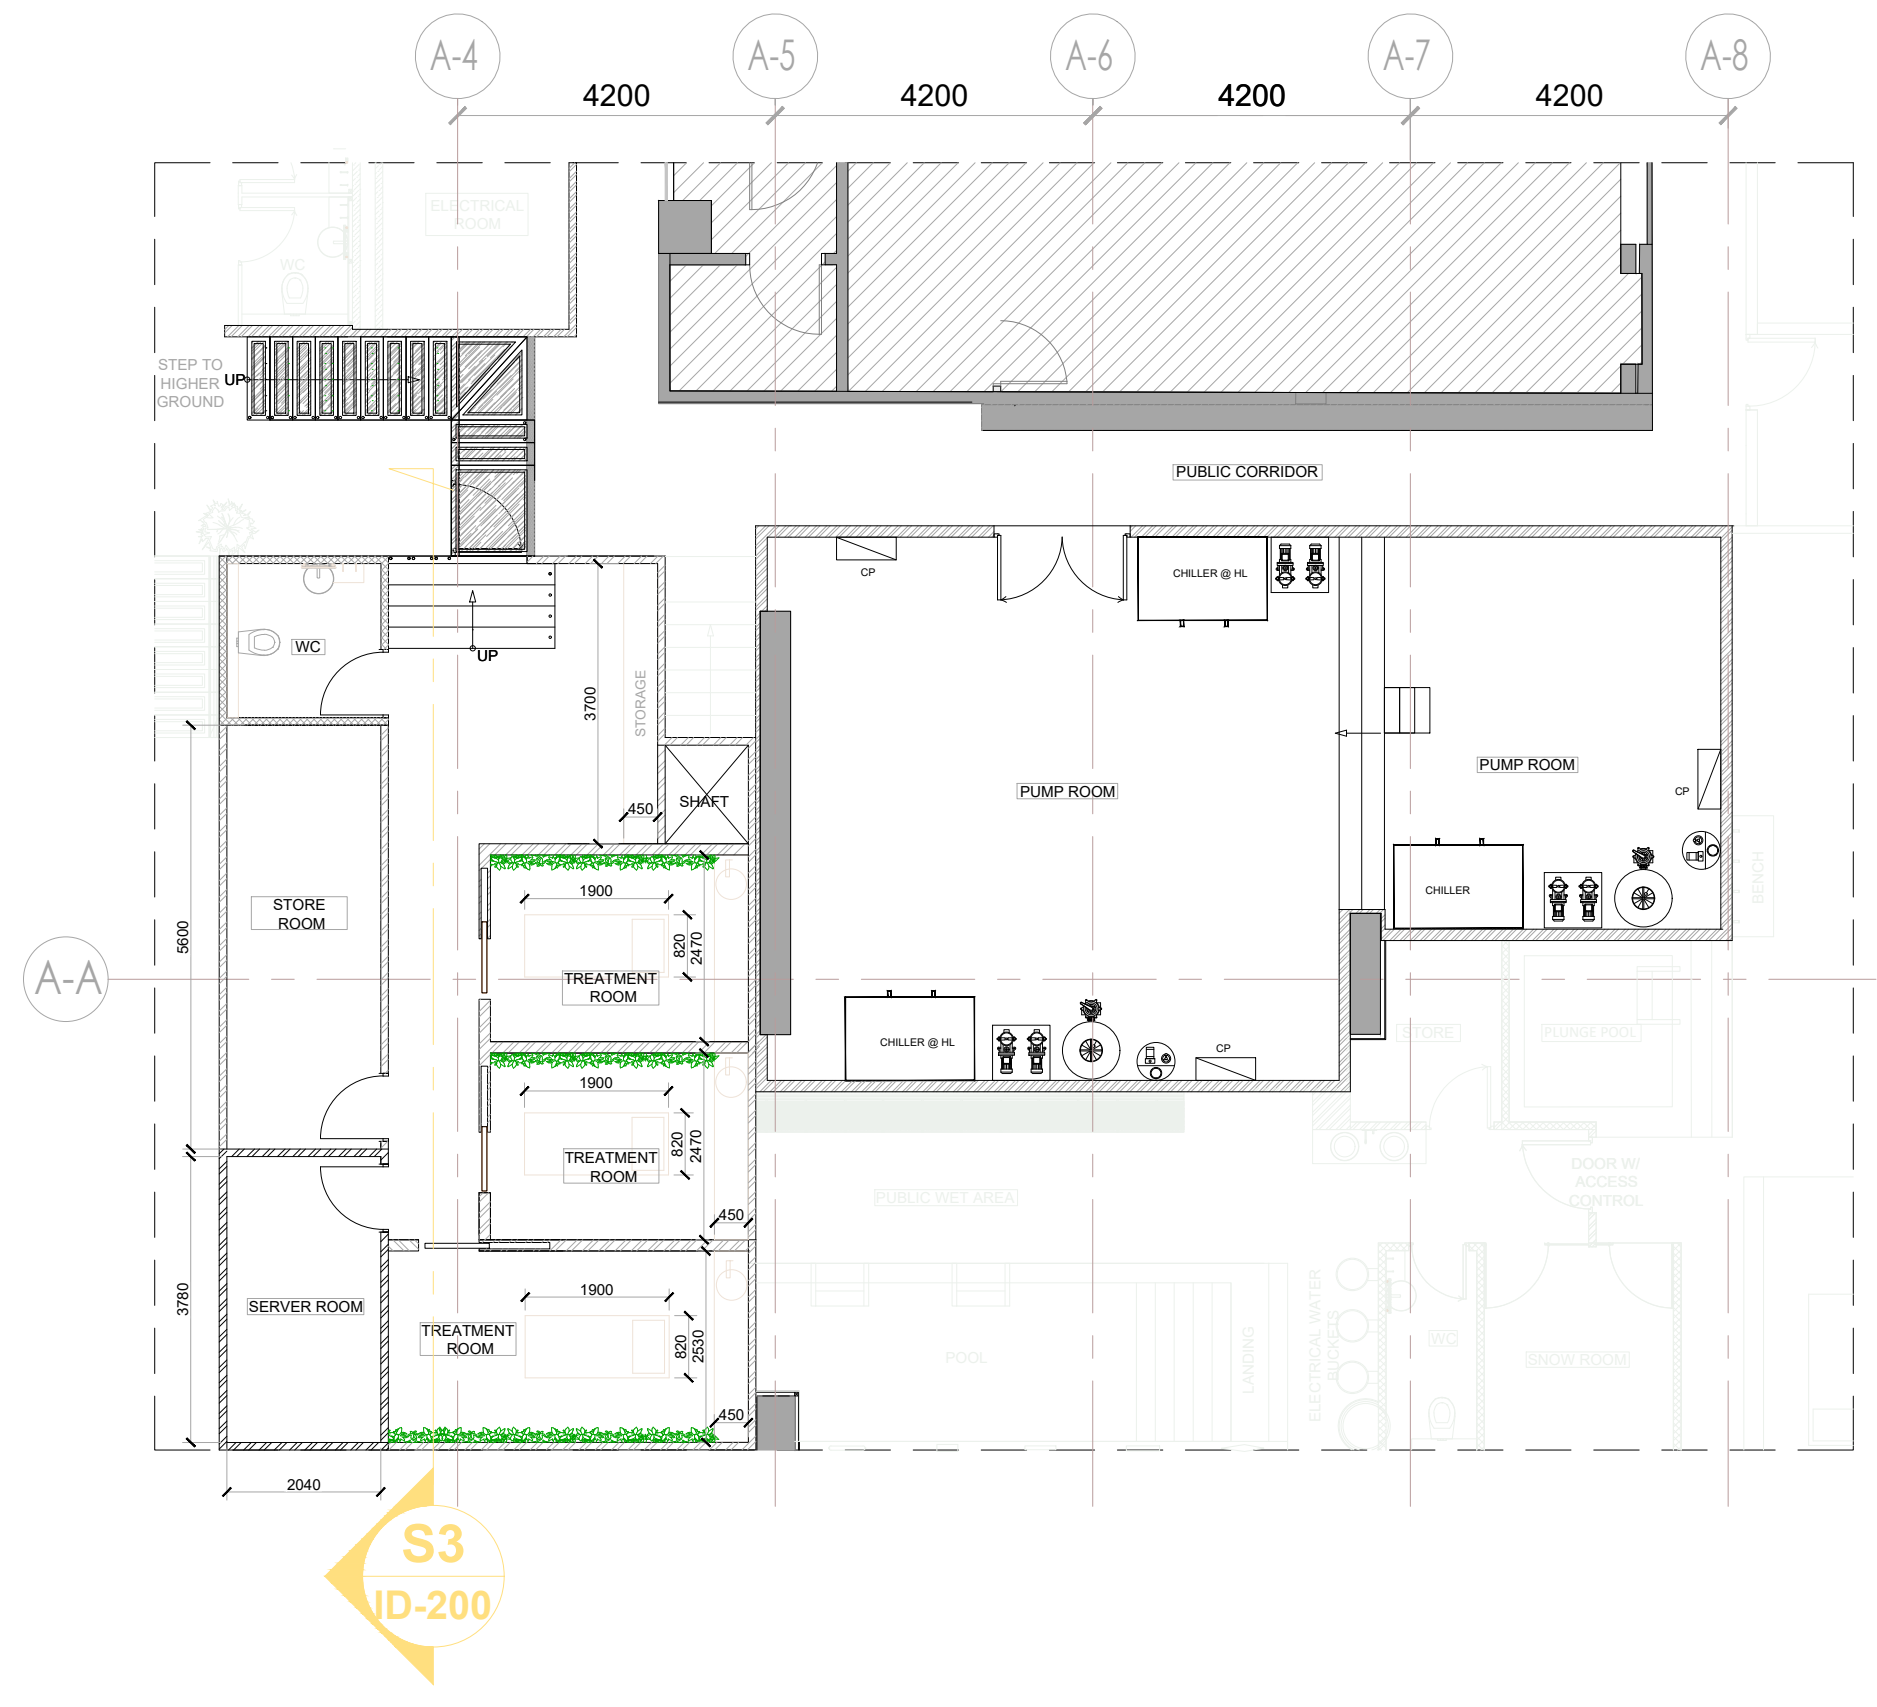

02 HIGHER GROUND & PUMP ROOM FURNITURE PLAN
SCALE: 1:200

GENERAL NOTES :
1. DO NOT SCALE OFF DRAWINGS.
2. CONTRACTOR SHALL VERIFY AND BE RESPONSIBLE FOR ALL DIMENSIONS ON SITE.
3. ARCHITECTS TO BE NOTIFIED OF ANY VARIATION BETWEEN SITE DIMENSIONS AND THOSE OF PLANS.
4. THESE DRAWINGS REMAIN THE PROPERTY OF DESIGN-INFINITY AND SHOULD NOT BE COPIED IN ANY FORM OR PASSED ON TO A THIRD PARTY WITHOUT PRIOR WRITTEN CONSENT.

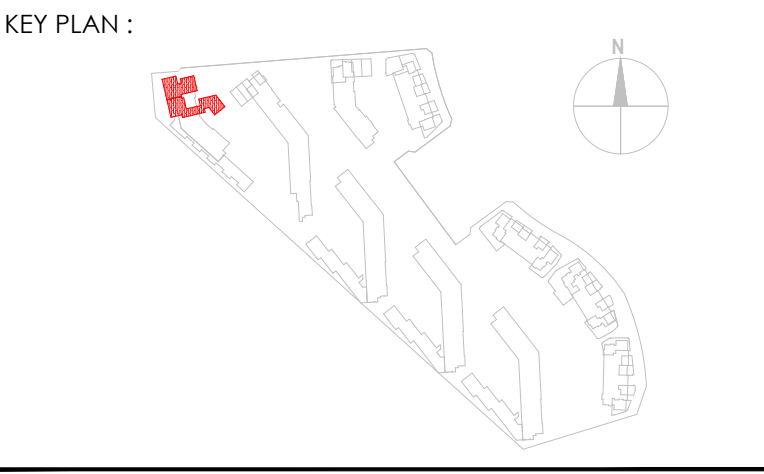

CLOUDED AREA REVISED

FOR APPROVAL

REV	DATE	DESCRIPTION
01	09-10-23	REVISED AS PER CLIENT COMMENTS
00	24-08-23	ISSUED FOR APPROVAL

DRAWING STATUS :
☐ A - APPROVED ☐ C - REVISE & RESUBMIT
☐ B - APPROVED AS NOTED ☐ D - REJECTED

SIGNATURE : _____ DATE : _____

PROJECT NAME:
BANYA FORREST
BLUE WATER ISLAND,
BLDG-NAME & NO : BW BOULEVARD, UNIT-R1 & R2,
MARSA DUBAI, UAE.



ID CONSULTANT:
BR&NDCREATIVE

STRUCTURE CONSULTANT :
RED CRYSTAL ENGINEERING CONSULTANCY
PO Box 30507, Dubai, United Arab Emirates
Tel: (+9714) 3599895 Fax: (+9714) 3599332

MEP CONSULTANT/ MAIN CONTRACTOR:
Design Infinity LLC
Interior Turnkey Solutions
Design Infinity LLC
PO Box 62622, Dubai, United Arab Emirates
Email: info@design-infinity.com
[www.design-infinity.com]
Tel: (+9714) 3795902 Fax: (+9714) 3795903

DRAWING TITLE:
GROUND FLOOR & HIGHER GROUND
FURNITURE DIMENSION PLAN

APPROVAL			
DESIGN BY			
DRAWN BY	VT		
CHECKED BY	AY		
DATE	13-Nov-23	SCALE	1:200 @ A3
DES. REF. NO.			
DRAWING No.			REV. NO.
BRC_BNM_DI_ID_101.1			01