


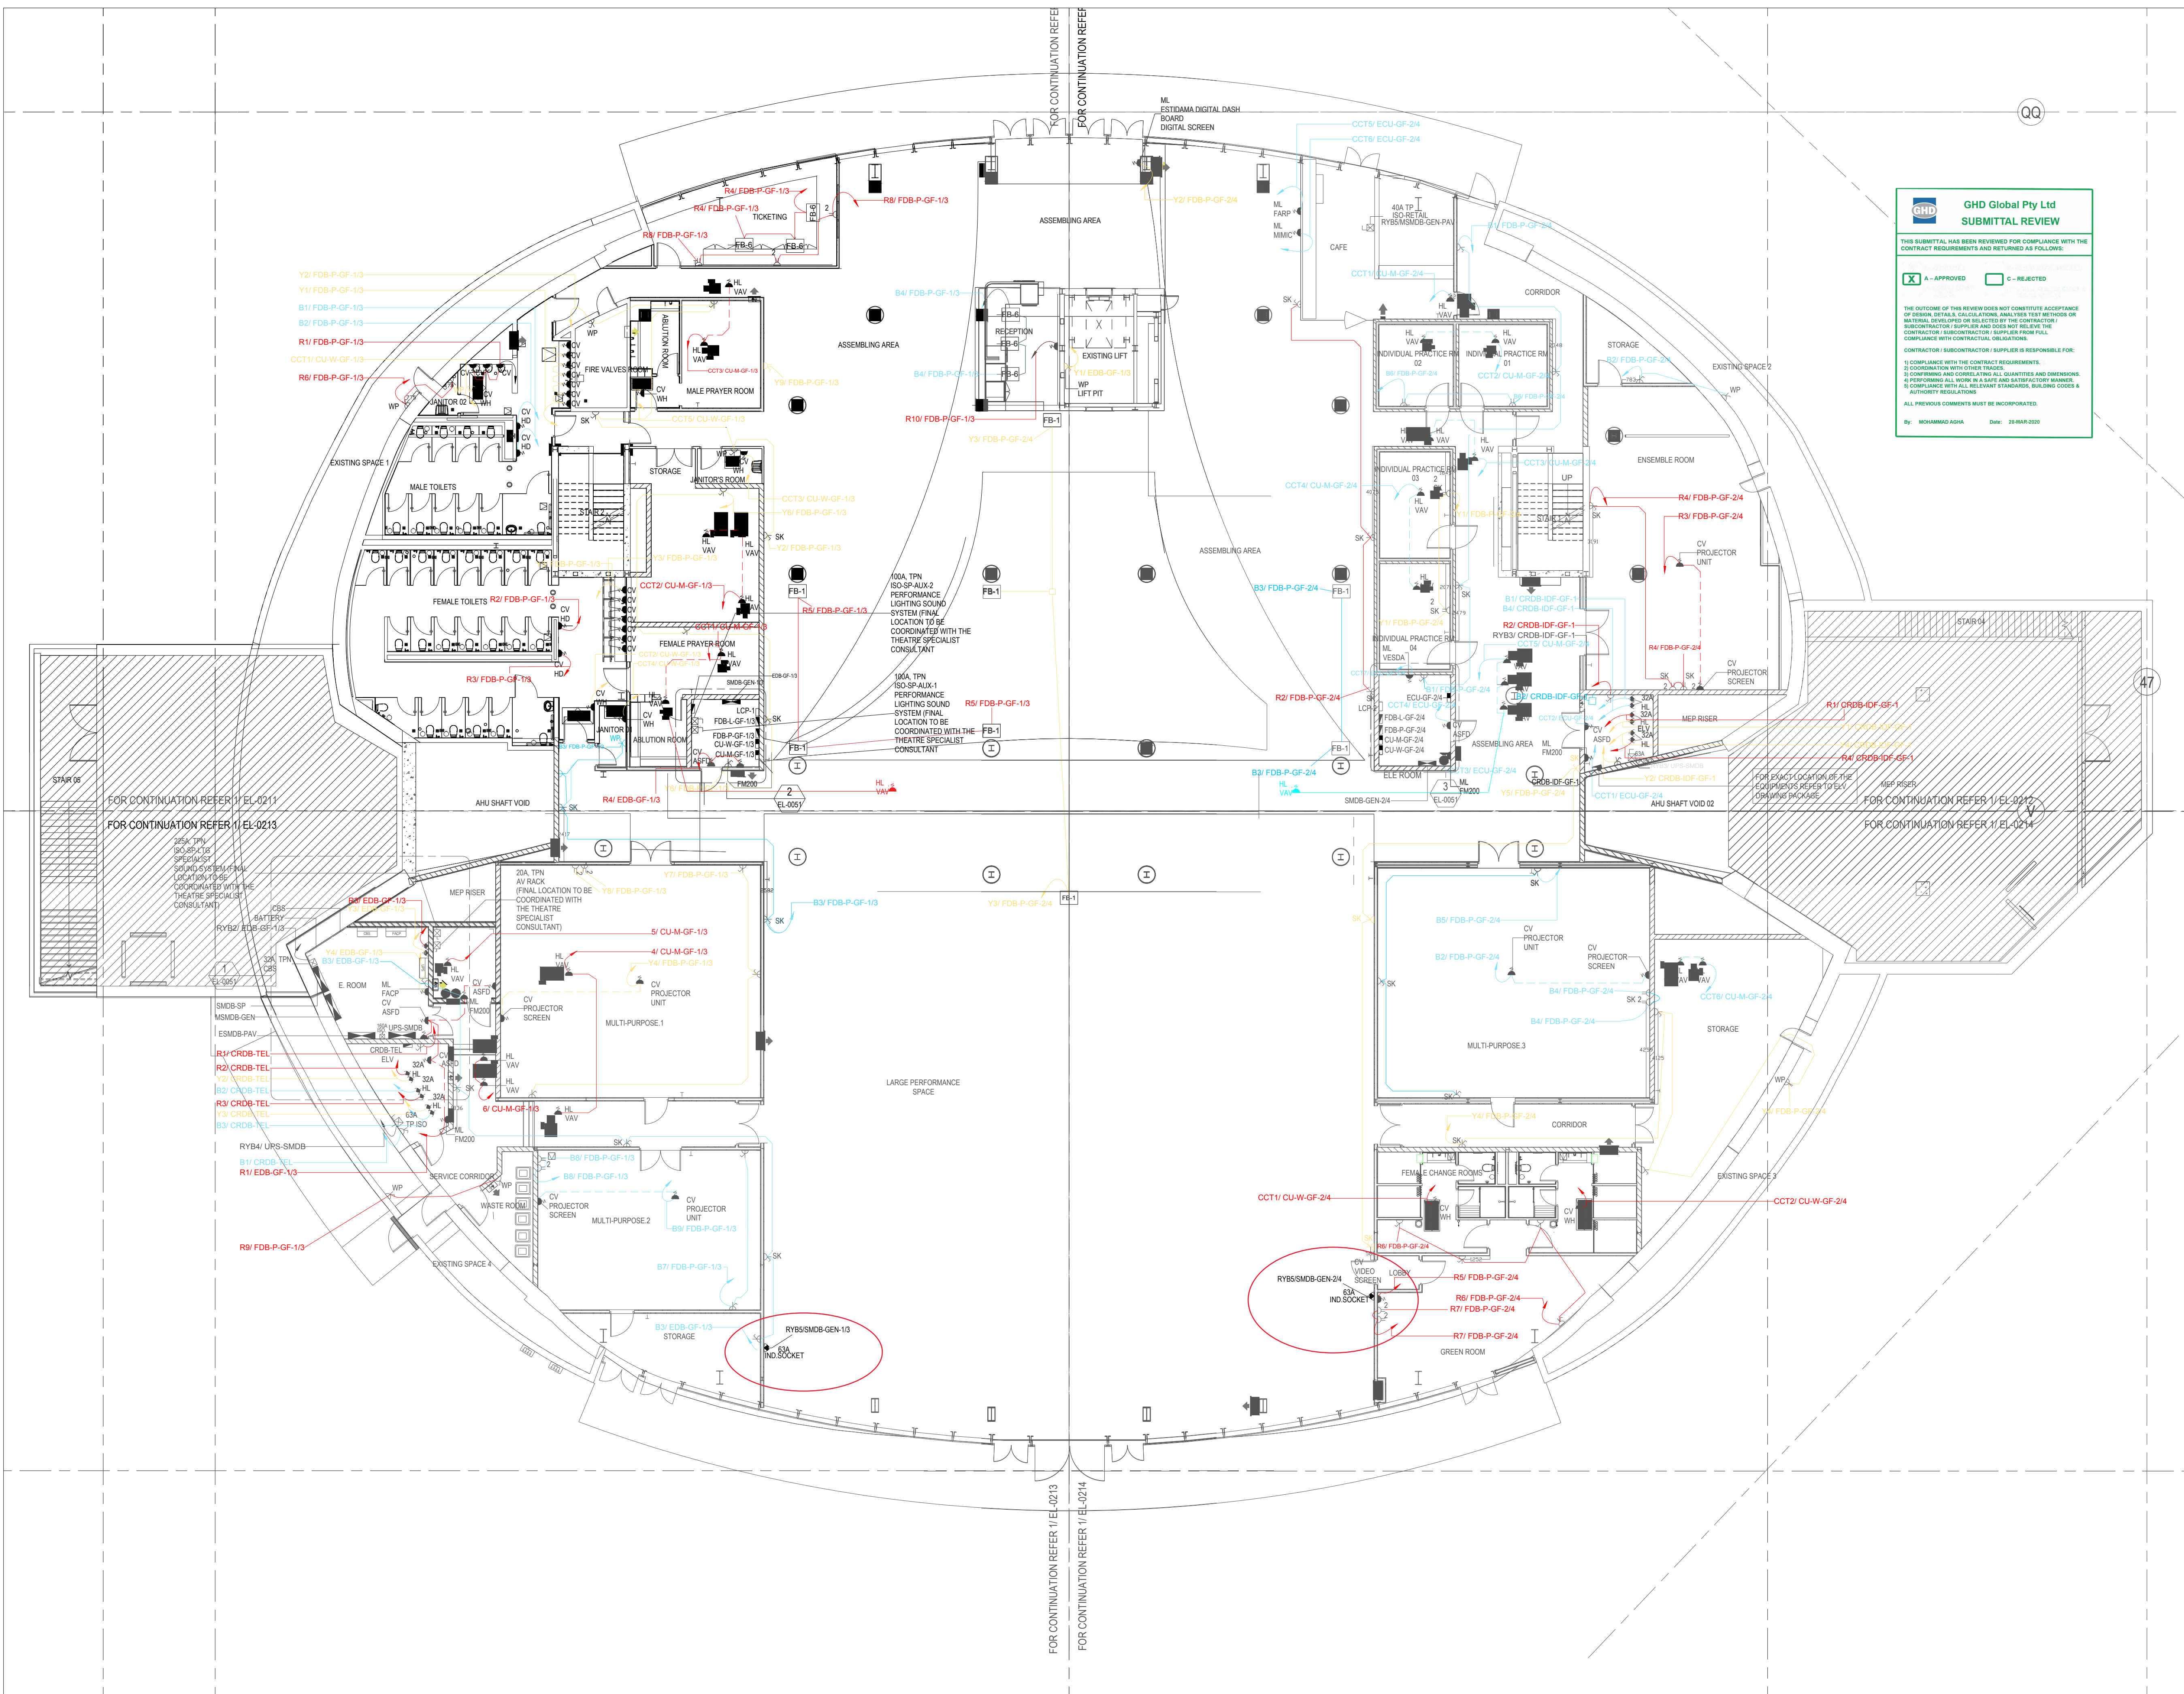

**GHD Global Pty Ltd**  
**SUBMITTAL REVIEW**

THIS SUBMITTAL HAS BEEN REVIEWED FOR COMPLIANCE WITH THE CONTRACT REQUIREMENTS AND RETURNED AS FOLLOWS:

☒ A - APPROVED

☐ C - REJECTED

THE OUTCOME OF THIS REVIEW DOES NOT CONSTITUTE ACCEPTANCE OF DESIGN, MATERIAL, CALCULATIONS, ANALYSIS, TEST METHODS OR MATERIAL DEVELOPED OR SELECTED BY THE CONTRACTOR / SUBCONTRACTOR / SUPPLIER AND DOES NOT RELIEVE THE CONTRACTOR / SUBCONTRACTOR / SUPPLIER FROM FULL COMPLIANCE WITH CONTRACTUAL OBLIGATIONS.

CONTRACTOR / SUBCONTRACTOR / SUPPLIER IS RESPONSIBLE FOR:

- 1) COMPLIANCE WITH THE CONTRACT REQUIREMENTS.
- 2) COORDINATION WITH OTHER TRADES.
- 3) CONFIRMING AND CORRELATING ALL QUANTITIES AND DIMENSIONS.
- 4) PERFORMING ALL WORK IN A SAFE AND SATISFACTORY MANNER.
- 5) COMPLIANCE WITH ALL RELEVANT STANDARDS, BUILDING CODES & AUTHORITY REGULATIONS.

ALL PREVIOUS COMMENTS MUST BE INCORPORATED.

By: **MOHAMMAD AGHA**      Date: **12-MAR-2020**

Copyright: GHD Global Pty Ltd. This document may only be used by GHD's client (and any other person who GHD has agreed can use this document) for the purpose for which it was prepared and must not be used by any other person or for any other purpose.

Key Plan:

**GENERAL NOTES**

A. ALL DIMENSIONS ARE IN METERS UNO.

B. ALL LEVELS ARE IN METERS ACCORDING TO NADD.

C. DO NOT SCALE FROM THIS DRAWING. ONLY WRITTEN DIMENSIONS SHALL BE FOLLOWED.

**REFERENCE :**  
UPAV-SCAN-SPD-EL-0210

**POWER LEGEND**

| WIRING ACCESSORIES |                                         |
|--------------------|-----------------------------------------|
| SYMBOL             | DESCRIPTION                             |
|                    | BS1363 SOCKET SWITCHED OUTLET           |
|                    | CONNECTION UNIT                         |
|                    | BS6891 SOCKET SWITCHED OUTLET           |
|                    | SINGLE 13A SWITCHED FLOOR SOCKET OUTLET |
|                    | SINGLE PHASE ISOLATOR                   |
|                    | SINGLE PHASE WEATHER PROOF ISOLATOR     |
|                    | THREE PHASE ISOLATOR                    |
|                    | THREE PHASE WEATHER PROOF ISOLATOR      |
|                    | DISTRIBUTION BOARD                      |
|                    | CONSUMER UNIT                           |
|                    | SUBMAIN DISTRIBUTION BOARD              |
|                    | MAIN DISTRIBUTION BOARD                 |
|                    | SQUARE RECTANGULAR FLOOR BOX            |
|                    | 3 COMPARTMENT SCEEDED TYPE              |
|                    | 1 TWIN SOCKET OUTLET                    |

**AS BUILT**

| Rev | Description                | Drawn | Chk'd | Date     |
|-----|----------------------------|-------|-------|----------|
| B   | AS PER CONSULTANT COMMENTS | SCAN  | S     | MAR-2020 |
| A   | ISSUED FOR APPROVAL        | SCAN  | S     | MAR-2020 |

CLIENT

**دائرة الثقافة والسياحة**  
**DEPARTMENT OF CULTURE AND TOURISM**

Lead Consultant / Architect / Structural / MEP

**GHD**

3rd Floor Guardian Tower  
Dana Community,  
Abu Dhabi  
United Arab Emirates,  
T: +971 2 446 8700  
F: +971 2 447 2815

Fire Life and Safety Consultant

**EXOVA**  
Worshipper

15th Floor, Al Amiri Towers  
TECOM Area,  
Dubai,  
United Arab Emirates,  
T: +971 4 439 5800  
F: +971 4 439 5699

Sustainability / PQP Consultant

**mustadam**

Mustadam Limited  
Master City, Incubator Building  
P.O. Box 120468 Abu Dhabi  
United Arab Emirates  
Tel: +971 2 642 4164  
Fax: +971 2 965 4161

IT/AV/Security Consultant

**Sab-TS (FZE)**  
Chris Salimani - Director  
Tel: +971 (0) 50 708425  
Email: Chris@Sab-TS.com  
Web: www.sab-ts.com  
PO Box: 215538

Specialist Lighting Consultant

**NULTY+**

MAIN CONTRACTOR:

**SCAN CONSTRUCTION**

P.O. BOX 8212, ABU DHABI, U.A.E. TEL: (02) 6288763 FAX: (02) 6272251

SUB CONTRACTOR:

**MADA INTERNATIONAL**  
ELECTROMECHANICAL CONSULTING

TEL: 02-5544866 FAX: 02-5544123  
M-44 Masrafah Industrial - Ebn Badran  
Zone Building, PO Box 114380, Abu Dhabi  
ad@madainternational.com

Project Name and Location

**UAE PAVILION REFURBISHMENT**  
**SAADIYAT ISLAND, ABU DHABI**  
**UNITED ARAB EMIRATE SC06-16**

Drawing Title

**ELECTRICAL POWER**  
**PAVILION GROUND FLOOR**  
**OVERALL PLAN**

| Drawn                | Checked  | Approved | Sheet No          |
|----------------------|----------|----------|-------------------|
| SCAN                 | S        | S        |                   |
| Scale (A1)           | Date     | Status   | Internal Revision |
| Scale (A1)           | MAR-2020 | AS BUILT |                   |
| Drawing No.          | Rev.     |          |                   |
| UPAV-SCAN-AB-EL-0003 | B        |          |                   |