


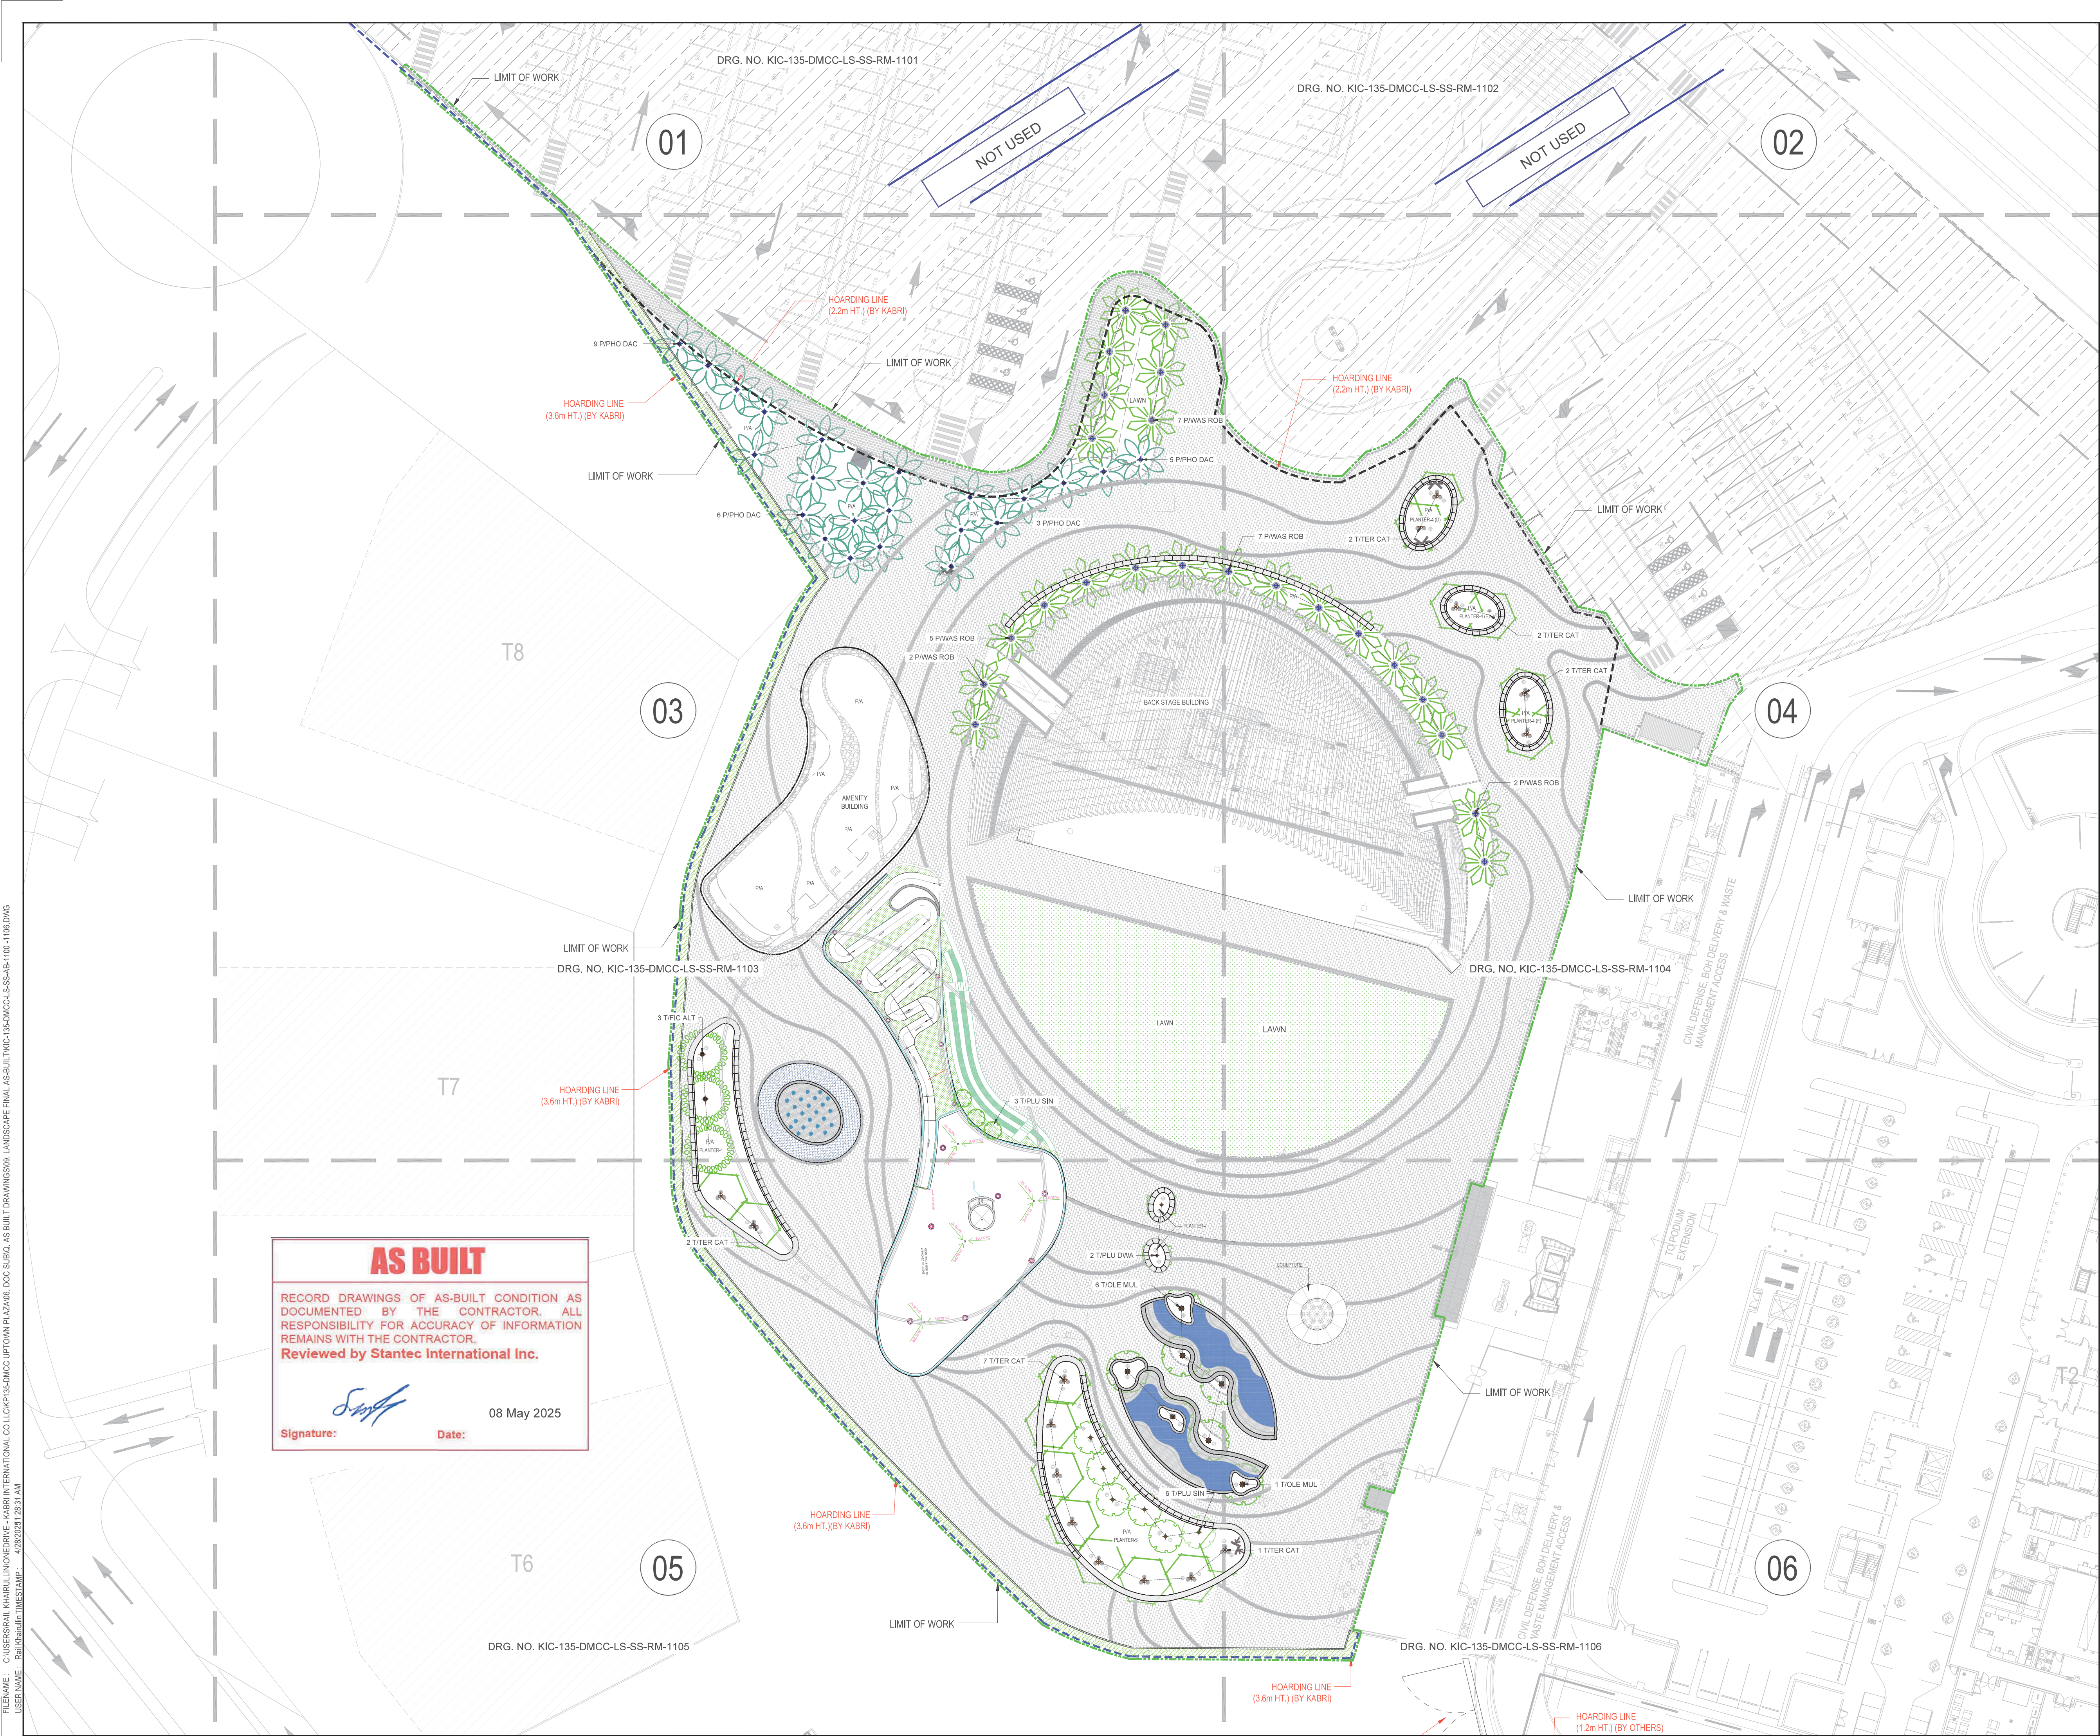

AS BUILT

RECORD DRAWINGS OF AS-BUILT CONDITION AS DOCUMENTED BY THE CONTRACTOR. ALL RESPONSIBILITY FOR ACCURACY OF INFORMATION REMAINS WITH THE CONTRACTOR.
Reviewed by Stantec International Inc.

[Signature] 08 May 2025
Signature: Date:

KEY PLAN :

NOTES

1. ALL DIMENSIONS ARE IN METERS UNLESS OTHERWISE NOTED.
2. THE COORDINATE SYSTEM USED IS BASED ON (DLTM) DUBAI LOCAL TRANSVERSE MERCATOR.

LEGEND

PALMS	CODE	BOTANICAL / COMMON NAME
	P/PHO DAC	Phoenix dactylifera / Date Palm
	P/WAS ROB	Washingtonia robusta / Mexican Fan Palm

TREES	CODE	BOTANICAL / COMMON NAME
	T/FIC ALT	Ficus altissima / Council Tree
	T/OLE MUL	Olea europaea / Olive Multi-Trunk
	T/PLU DWA	Plumeria obtusa 'Dwarf' / Dwarf Plumeria
	T/PLU SIN	Plumeria obtusa / Singapore Plumeria
	T/TITER CAT	Terminalia catappa / Indian almond

--- LIMIT OF WORK

00	14.04.2025	ISSUED FOR APPROVAL	RK	ES	AS
REV.	DATE	DESCRIPTION	Drwn	Chkd	Appr

AS-BUILT DRAWING

PROJECT TITLE :
**DMCC UPTOWN PLAZA
CONSTRUCTION WORKS- UPTOWN
DUBAI DISTRICTS**

CLIENT / DEVELOPER :
DMCC

LEAD DESIGNCONSULTANT :
Stantec

STANTEC INTERNATIONAL INC.
MSM 2 Building, 1st Floor Al Safa 1, Sheikh Zayed Road
PO Box 3020 Dubai, UAE

CONTRACTOR :
KABRI
International Co. L.L.C
U.A.E U.S.A JORDAN
Kabri International Co. L.L.C
www.Kabrilc.com

DRAWING TITLE
**OVERALL PALMS AND TREES
PLAN (INDEX PLAN)**

SHEET No 01 OF 01	SCALE 1:600	ORIGINAL SIZE A1
PROJECT STAGE CLOSE OUT	DOCUMENT STATUS FOR APPROVAL	
DRAWING No KIC-135-DMCC-LS-SS-AB-1100	REVISION 00	